

Cherokee County Health Department
ON-SITE SEWAGE MANAGEMENT SYSTEM INSPECTION REPORT

County Code 0 2 8	Construction Permit 	Case Number (FHA, VA, etc.) 	Health Dist. 	Day 0 3	Month 1 1	Year 0 0
--	--	--	---	--	--	---

Property Location <i>LOT # 10 Billings Farm</i>	Property Owner <i>Steve Folsom</i>
Sewage Disposal Contractor <i>Steve Folsom</i>	
County	

ALL ITEMS: Blank = Not Applicable; 0 = Unknown

*ITEMS: 1 = Yes; 2 = No

SECTION A - GENERAL

1. Type Water Supply: (1) Public, (2) Community, (3) Indiv.	1
2. Financial Assistance: (1) FHA, (2) VA, (3) Farmers Home, (4) Conventional, (5) Other	4
3. House Structure: (1) New, (2) Existing < 1 year, (3) Existing > 1 year	1
4. Sewage Disposal Installation: (1) New, (2) Repair to existing sys.	1
5. If Repair of Existing System - Years System Installed: (1) < 1 year, (2) 1 - 2, (3) 2 - 3, (4) 3 - 5, (5) 5 - 10, (6) > 10	3
6. Percolation Rate Min./In.:	42
7. *Is Property Part of a Subdivision:	1

SECTION B - FACILITY

1. **Type Facility: See Code Below	01
2. Water Usage Determined by: (1) No. Bedrooms, (2) No. Gallons	1
3. Number Bedrooms or Gallons:	3

SECTION C - LOT SIZE

1. Lot Depth (Average):	40
2. Lot Width (Average):	41
3. Building Line (Feet):	42

SECTION D - PRIMARY TREATMENT

1. Sewage Disposal Method: (1) Septic Tank, (2) Construction Privy, (3) Pit Privy, (4) Aerobic Unit, (5) Other	1
2. Septic Tank Capacity (gallons): <i>8000</i>	15
3. Unit 1 Tank/Compartment Capacity: <i>2000</i>	45
4. Septic Tank Inside Length (feet):	49
5. Septic Tank Inside Width (feet):	50
6. Septic Tank Liquid Depth (feet):	51
7. Septic Tank Material: (1) Precast concrete, (2) Poured in place, (3) Other	1
8. Dosing Tank Capacity (gallons):	53
9. Grease Trap Capacity (gallons):	54
10. Distance Septic Tank from Well:	57

SECTION E - SECONDARY TREATMENT

1. Field Layout Method: (1) Distribution Box, (2) Level Field, (3) Serial, (4) Mound, (5) Other <i>Injection Method</i>	3
2. Absorption Field:	60
a. Total Square Feet	70

b. Total Linear Feet	25
c. Length each Trench (feet)	65
d. Width of Trenches (inches)	36
e. Number of Trenches	5
f. Distance between Trenches	29
g. Average Trench Depth (inches)	48
h. * Aggregate Proper Size	
i. * Aggregate Proper Depth	
j. Distance from Building Foundation	
k. Nearest Property Line: (1) Front, (2) Rear, (3) R. Side, (4) L. Side	
l. Distance Nearest Property Line	
m. Distance Privy or Absorption Field from Well	

SECTION F - HEALTH AGENCY TIME


1. Total Inclusive Time (min.):	25
---------------------------------	----

SECTION G - SYSTEM APPROVED

1. * Yes	
2. No	1

Sketch

1. **Type Facility
- (1) Residence
 - (2) Apartment
 - (3) Institution
 - (4) Service Station
 - (5) Restaurant
 - (6) Church
 - (7) Tourist Accommodation
 - (8) Launderette
 - (9) Mobile Home Park
 - (10) Other
- (Specify) _____

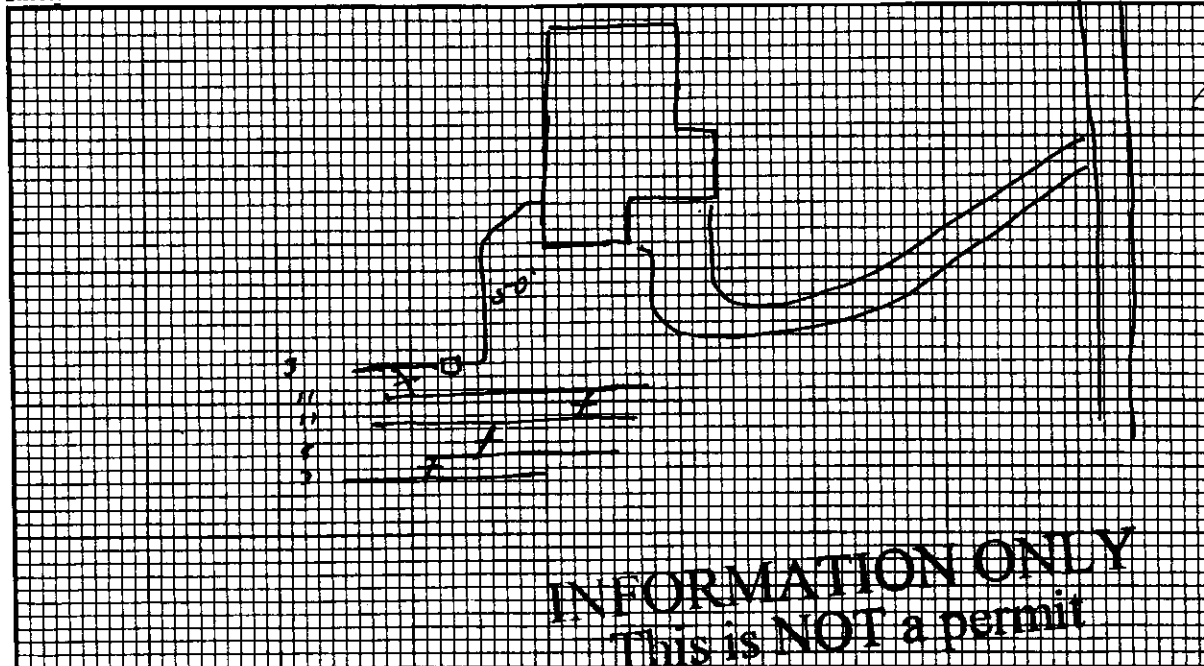

INFORMATION ONLY

This is NOT a permit

Remarks:

Inspected By: <i>William Ayfe</i>	Title: <i>IEH CM</i>	Health Agency: <i>Cherokee Co</i>
--------------------------------------	-------------------------	--------------------------------------